

Revisions				217251	H
LAL	Rev	Description	Chk	Date	Approved
	A	ENGRG RELEASE	BN	10-26-78	
	B	ADDED NOTE 2 (CUT ETCH AND ADD JUMPER) M/L ITEM 10 QTY WAS 2, ITEM 12 QTY WAS 3, ADDED ITEM 24 I.C. S08 QTY 1, D7. M/L ITEM 47 QTY WAS 8, ITEM 50 QTY WAS 1, ITEM 56 QTY WAS 16. ADDED M/L ITEM 14.	BN	1-17-79 2-28-79	
X	C	M/L ITEM 13 ADDED F2. ADDED ITEM 17 74LS138 QTY 1, G1. REMOVED G1 FROM M/L ITEM 16. ITEM 47 5.1K WAS 5K, 116447-502. ITEM 51 510 OHMS WAS 500 OHMS 116447-501. ITEM 56 QTY WAS 16.	BN	3-27-79	
X	D	DELETED NOTE 2-108, & 109). ADDED NOTE 2-126), 127), & 128). M/L ITEM 11 REMOVED F8. M/L ITEM 19 REMOVED D4. ADDED ITEM 61, 62, 63.	BN	4-2-79	
	E	ADDED COMP. REF DESIGNATIONS	BN		
	F	LOGIC UPDATED	BN		
	G	LOGIC UPDATED	BN		
X	H	ADDED NOTES 2-129) THRU 2-165) M/L ITEM 14 WAS 74LS74.	BN	4-23-79	

ENGINEERING
RELEASE

THIS DOCUMENT CONTAINS 22 SHEETS.

NTDD1-PWASSY.SIL (PNTDD-PWASSY.DM)

Dist Code **SPG**

<p>These drawings and specifications and the data contained therein, are the exclusive property of Xerox Corporation and/or Rank Xerox, Ltd. Issued in strict confidence and shall not, without the prior written permission of Xerox Corporation or Rank Xerox, Ltd. be reproduced, copied or used for any purpose whatsoever except the manufacture of articles for Xerox Corporation or Rank Xerox.</p>	<p>Notes Unless Specified</p>	<p>Drawn NISHIMURA</p>	<p>Xerox Corporation El Segundo, California XEROX</p>		
	<p>1. Tolerances .xx \pm .03 Angular .xxx \pm .010 \pm 1/2°</p>	<p>Check BN 4-23-79</p>	<p>ASSEMBLY, PRINTED WIRING- DISK & DISPLAY (NOTETAKER)</p>		
	<p>2. Break All Sharp Edges .010 Approx —</p> <p>3. Mach. Surfaces ✓</p> <p>4. All Dim. In Inches</p>	<p>Appr.</p> <p>Material</p>			
	<p>Model No. First Use NOTETAKER</p>	<p>Finish</p>	<p>Code Ident 18338</p>	<p>Size A</p>	<p>Dwg. No. 217251</p>
<p>Next Assy. First Use 217684</p>		<p>Scale NONE</p>	<p>Do Not Scale Drawing</p>	<p>Shoot 1 OF</p>	

NOTES: UNLESS OTHERWISE SPECIFIED

1. ASSEMBLE PER MODULE ASSY SPEC, DWG NO. 216207.
2. THE FOLLOWING MODIFICATIONS ARE REQUIRED USING 'A' REVISION PW BOARD:

- 1) DRILL OUT FEEDTHRU LOCATED BETWEEN 1E8 AND 1E9 UNTIL THERE IS NO CONTINUITY BETWEEN 2A1 AND 1G7 OR 1G7 AND 6D19 (COMP. SIDE).
- 2) CUT ETCH BETWEEN 4C9 AND 4D6 (ETCH SIDE).
- 3) DRILL OUT 4E10 SO THERE IS NO CONTINUITY BETWEEN 4E10 AND 4C11.
- 4) CUT ETCH BETWEEN 6D14 AND ITS FEED-THRU (COMP. SIDE).
- 5) 6D13
- 6) 6D12
- 7) 6D11
- 8) 6D10 AND ITS FEED-THRU (COMP. SIDE).
- 9) 6D9 AND 6F7 (ETCH SIDE).
- 10) 6D9 AND FEED-THRU NEAR 5B4 (ETCH SIDE).
- 11) 6D8 AND FEED-THRU NEAR 5B11 (ETCH SIDE).
- 12) 6D7 AND FEED-THRU NEAR 5B10 (ETCH SIDE).
- 13) 6D8 AND 6F6 (ETCH SIDE).
- 14) 6D7 AND 6F5 (ETCH SIDE)
- 15) 9G12 AND 9G4 (COMP. SIDE).
- 16) 8F10 AND FEED-THRU NEAR 8G14 (CONNECTS TO 10G11) (ETCH SIDE).
- 17) 8F11 AND FEED-THRU NEAR 8C12 (CONNECTS TO 8C13) (ETCH SIDE).
- 18) 10G12 AND 9G14 (COMP. SIDE).
- 19) 7D13 AND FEED-THRU (CONNECTS TO 9G4) (ETCH SIDE).
- 20) 4F12 AND 8G12 (COMP. SIDE).
- 21) CUT ETCH BETWEEN 9D13 AND FEED-THRU (CONNECTS TO 10E12) (ETCH SIDE).

(NOTE 2 CONT'D ON SHEET 3)

NTDD2-PWASSY.SIL

These drawings and specifications, and the data contained therein, are the exclusive property of Xerox Corporation and or Rank Xerox, Ltd. Issued in strict confidence and shall not, without the prior written permission of Xerox Corporation or Rank Xerox, Ltd., be reproduced, copied or used for any purpose whatsoever, except the manufacture of articles for Xerox Corporation or Rank Xerox, Ltd.

Title
**ASSY, PRINTED WIRING-
 DISK & DISPLAY**

Xerox Corporation El Segundo, California		XEROX	
217251		, H	
Sheet	2	Of	

(NOTE 2 CONT'D)

22) DRILL OUT 7D11 SO THERE IS NO CONTINUITY BETWEEN 7D11 AND 8D2.

23) CUT ETCH BETWEEN 9C6 AND 9G14 (ETCH SIDE).

24) 8C2 7B15

25) 8C3 7B14

26) 8C4 7B13

27) 8C5 7B12

28) 8C10 7C15

29) 8C11 7C14

30) 8C12 7C13

31) 8C14 7C12

32) 9C2 8B15

33) 9C3 8B14

34) 9C4 8B13

35) 9C5 8B12

36) 9C11 9B14

37) 9C12 9B13

38) 9C14 9B12

39) 2B4 PIN 66 (ETCH SIDE).

40) 9F1 10F14 (COMP. SIDE).

41) 7F9 4F11 (COMP. SIDE).

42) 7F9 FEEDTHRU NEAR 9F7 (COMP. SIDE).

43) 8D1 FEEDTHRU UNDER 8G(CONN TO 10G4)(ETCH SIDE).

44) 8D1 FEEDTHRU UNDER 6D (COMP. SIDE).

45) 4B16 FEEDTHRU (ETCH SIDE).

46) CUT ETCH BETWEEN 4B19 AND 1B3 (COMP. SIDE).

(NOTE 2 CONT'D ON SH 4)

NTDD3-PWASSY.SIL

These drawings and specifications, and the data contained therein, are the exclusive property of Xerox Corporation and/or Rank Xerox, Ltd. They are issued in strict confidence and shall not, without the prior written permission of Xerox Corporation or Rank Xerox, Ltd., be reproduced, copied or used for any purpose whatsoever, except the manufacture of articles for Xerox Corporation or Rank Xerox, Ltd.

Title
ASSY, PRINTED WIRING-
DISK & DISPLAY

Xerox Corporation El Segundo, California		XEROX	
217251		H	
Sheet	3	Of	

(NOTE 2 CONT'D)

47) CUT ETCH BETWEEN 1A9 AND CR1 + (COMP. SIDE).

48) CUT ETCH BETWEEN CR1 + AND FEEDTHRU NEAR 6B16 (COMP. SIDE).

49) CUT ETCH BETWEEN 6D24 AND 1E13 (COMP. SIDE).

50) DRILL OUT 9C10 SO THERE IS NO CONTINUITY TO 9B15.

51) DRILL OUT 2C10 SO THERE IS NO CONTINUITY TO EITHER 1C9 OR 2B13.

52)

53) ADD JUMPER FROM 4C9 TO 2A1 (ETCH SIDE).

54) 4C9 6D19

55) 4D6 4D7

56) 2F3 4C11

57) 2F2 1G15

58) ADD JUMPER FROM 2F1 TO 6D2 (ETCH SIDE).

59) INSTALL 10K OHM, 1/4 W RESISTOR (ITEM 47) BETWEEN FEEDTHRU NEAR 9F14 (CONNECTS TO 8F13) AND 8F14 (ETCH SIDE).

60) ADD JUMPER FROM 6D7 TO 4F25 (ETCH SIDE).

61) 6D8 4F24

62) 6D9 4F23

63) 6D10 4F22

64) 6D11 4F21

65) 6D12 4F20

66) 6D13 4F19

67) 6D14 4F18

68) 6F5 6B6

69) 6F6 6B5

70) ADD JUMPER FROM 6F7 TO 6B4 (ETCH SIDE).

(NOTE 2 CONT'D ON SH 5)

NTDD4-PWASSY.SIL

These drawings and specifications, and the data retained therein, are the exclusive property of Xerox Corporation and or Rank Xerox, Ltd. Issued in strict confidence and shall not, without the prior written permission of Xerox Corporation Rank Xerox, Ltd., be reproduced, copied or used for any purpose whatsoever, except the manufacture of articles for Xerox Corporation or Rank Xerox, Ltd.

Title
ASSY, PRINTED WIRING-
DISK & DISPLAY

Xerox Corporation
El Segundo, California
XEROX
217251
H
Sheet 4 of

(NOTE 2 CONT'D)

71) ADD JUMPER FROM 9G12 TO 8F2 (ETCH SIDE).

72) 8C13 10G11

73) 8G12 8F11

74) 9G10 10G12

75) 7D5 8F10

76) 7D6 7D13

77) 7D4 9G4

78) 8F10 4F12

79) 9D13 2D12

80) 7D11 2D1

81) 2D2 8D2

82) 9C6 9C8

83) 8C2 7C12

84) 8C3 7C13

85) 8C4 7C14

86) 8C5 7C15

87) 8C10 7B12

88) 8C11 7B13

89) 8C12 7B14

90) 8C14 7B15

91) 9C2 9B12

92) 9C3 9B13

93) 9C4 9B14

94) 9C5 9B15

95) ADD JUMPER FROM 9C10 TO 8B12 (ETCH SIDE).

(NOTE 2 CONT'D ON SH 6)

NTDD5-PWASSY.SIL

These drawings and specifications, and the data contained therein, are the exclusive property of Xerox Corporation and or Rank Xerox, Ltd. Issued in strict confidence and shall not, without the prior written permission of Xerox Corporation Rank Xerox, Ltd., be reproduced, copied or used for any purpose whatsoever, except the manufacture of articles for Xerox Corporation or Rank Xerox, Ltd.

Title

ASSY, PRINTED WIRING-

DISK & DISPLAY

Xerox Corporation
El Segundo, California

XEROX

217251

,H

Sheet

5

of

(NOTE 2 CONT'D)

- 96) ADD JUMPER FROM 9C11 TO 8B13 (ETCH SIDE).
- 97) 9C12 8B14
- 98) 9C14 8B15
- 99) 9F1 10B9
- 100) 10B8 10F14
- 101) 10B10 9E2
- 102) 2B4 PIN 67
- 103) 1C9 2B13
- 104) 2C10 2D14
- 105) 4F11 9G2
- 106) 7F9 7F10 (ETCH SIDE).
- 107) 10G4 EDGE CONN PIN 54 FEEDTHRU (ETCH SIDE).
- 108) ~~7E1~~ ~~10D1~~ (ETCH SIDE).
- 109) ~~8D1~~ ~~2D13~~
- 110) 1E8 2E8
- 111) 1E16 2E16
- 112) 4B16 2D11
- 113) 4B19 2D3
- 114) 2D10 1B2
- 115) 2D4 1B3
- 116) 1A9 6D35
- 117) ADD JUMPER FROM 6D24 TO 1E14 (ETCH SIDE).
- 118) DRILL OUT 4E8 SO THERE IS NO CONTINUITY TO 2F13.
- 119) CUT ETCH BETWEEN 4E9 AND FEED THRU UNDER 1E (CONNECTS TO 1G15) (COMP. SIDE).
- 120) CUT ETCH BETWEEN 10F2 AND 8F12 (COMP. SIDE).

(NOTE 2 CONT'D ON SHEET 7)

NTDD6-PWASSY.SIL

so drawings and specifications, and the data contained therein, are the exclusive property of Xerox Corporation and or Rank Xerox, Ltd. Issued in strict confidence and shall not, without the prior written permission of Xerox Corporation Rank Xerox, Ltd., be reproduced, copied or used for any purpose whatsoever, except the manufacture of articles for Xerox Corporation or Rank Xerox, Ltd.

Title
ASSY, PRINTED WIRING-
DISK & DISPLAY

Xerox Corporation El Segundo, California		XEROX
217251		H
Sheet	6	of

(NOTE 2 CONT'D)

- 121) ADD JUMPER FROM 8F12 TO 4E3 (ETCH SIDE).
- 122) ADD JUMPER FROM 4E5 TO 10F2 (ETCH SIDE).
- 123) ADD JUMPER FROM 4E1 TO 9F4 (ETCH SIDE).
- 124) ADD JUMPER FROM 4E2 TO 4E4 (ETCH SIDE).
- 125) ADD JUMPER FROM 4E4 TO 4D10 (ETCH SIDE).
- 126) ADD JUMPER FROM 2D13 TO 7E1 (ETCH SIDE).
- 127) ADD JUMPER FROM 7E3 TO 8D1 (ETCH SIDE).
- 128) ADD CAPACITOR (ITEM 61) FROM 2D13 TO 2D7 (ETCH SIDE).
- 129) REMOVE WIRE FROM 4E5 TO 10F2 (ETCH SIDE).
- 130) ADD WIRE FROM 4E1 TO 4E13 (ETCH SIDE).
- 131) ADD WIRE FROM 4E5 TO 4E12 (ETCH SIDE).
- 132) ADD WIRE FROM 4E2 TO 4E10 (ETCH SIDE).
- 133) ADD WIRE FROM 10C11 TO 4E11 (ETCH SIDE).
- 134) ADD WIRE FROM 4E8 TO PL-11 (FEED THRU HOLE NEAR 6A) (ETCH SIDE).
- 135) ADD WIRE FROM 4E9 TO 9E2 (ETCH SIDE).
- 136) CUT ETCH BETWEEN 10F6 AND FEED THRU UNDER 10E (CONNECTS TO 9E2) (ETCH SIDE).
- 137) CUT ETCH BETWEEN 10F7 AND P-11 (COMP. SIDE).
- 138) CUT ETCH BETWEEN 10C11 AND FEED THRU NEAR 10F13 (CONN TO 10F4) (ETCH SIDE).
- 139) CUT ETCH BETWEEN 10F1 AND FEED THRU NEAR 10F4 (CONNECTS TO 9F4) (ETCH SIDE).
- 140) CUT ETCH BETWEEN 10F3 AND 10F5 (ETCH SIDE).
- 141) CUT ETCH BETWEEN 10E4 AND 9E13 (COMP. SIDE).
- 142) ADD WIRE FROM 10E4 TO 9E12 (ETCH SIDE).
- 143) CUT ETCH BETWEEN 10G3 AND 10G2 (ETCH SIDE).
- 144) CUT ETCH BETWEEN 10G8 AND 10G9 (ETCH SIDE).

(NOTE 2 CONT'D ON SH 7B)

NTDD7-PWASSY.SIL

These drawings and specifications, and the data contained therein, are the exclusive property of Xerox Corporation and or Rank Xerox, Ltd. Issued in strict confidence and shall not, without the prior written permission of Xerox Corporation Rank Xerox, Ltd., be reproduced, copied or used for any purpose whatsoever, except the manufacture of articles for Xerox Corporation or Rank Xerox, Ltd.

Title
ASSY, PRINTED WIRING-

DISK & DISPLAY

Xerox Corporation El Segundo, California		XEROX	
217251		H	
Sheet	7	Of	

(NOTE 2 CONT'D FROM SH 7)

- 145) CUT ETCH BETWEEN 10G9 AND FEED THRU ABOVE Q1 (CONN TO 4F10) (COMP. SIDE).
- 146) ADD WIRE FROM 10G2 TO 10G9 (ETCH SIDE).
- 147) ADD WIRE FROM 10F6 TO 10G3
- 148) ADD WIRE FROM 10F7 TO 10G8
- 149) ADD WIRE FROM 10F1 TO 10E2
- 150) ADD WIRE FROM 10F2 TO 10F3
- 151) ADD WIRE FROM 10F3 TO 4F25
- 152) ADD WIRE FROM 10F4 TO 10C8 (ETCH SIDE).
- 153) CUT ETCH BETWEEN 4F8 AND 7F10 (COMP. SIDE).
- 154) REMOVE JUMPER FROM 7F10 TO 7F9 (ETCH SIDE).
- 155) CUT ETCH BETWEEN 7F8 AND FEED THRU (CONN TO P2-44) (ETCH SIDE).
- 156) ADD WIRE FROM 4F8 TO 10A13 (ETCH SIDE).
- 157) ADD WIRE FROM 10A12 TO FEED THRU THAT CONN TO P2-44 (ETCH SIDE).
- 158) CUT ETCH BETWEEN 2G9 AND 1G11 (COMP. SIDE).
- 159) ADD WIRE FROM 2G9 TO 1F15 (ETCH SIDE).
- 160) ADD WIRE FROM 10C9 TO 1G7 (ETCH SIDE).
- 161) ADD WIRE FROM 10C10 TO 7E2 (ETCH SIDE).
- 162) CUT ETCH BETWEEN 1G11 AND FEED THRU (CONN TO 1F15) (ETCH SIDE).
- 163) DRILL OUT 2F4 SO THERE IS NO CONTINUITY TO 6F22.
- 164) ADD WIRE FROM 2F4 TO 2F5 (ETCH SIDE).

165) Remove 36MHz xtal from socket from board and solder oscillators directly in.

166) Make connection noted on page 15 (Reg. Circuit ' → Load Disp Addr')

NTDD7B-PWASSY.SIL

These drawings and specifications, and the data contained therein, are the exclusive property of Xerox Corporation and or Rank Xerox, Ltd. Issued in strict confidence and shall not, without the prior written permission of Xerox Corporation Rank Xerox, Ltd., be reproduced, copied or used for any purpose whatsoever, except the manufacture of articles for Xerox Corporation or Rank Xerox, Ltd.

Title

ASSY, PRINTED WIRING-
DISK & DISPLAY

Xerox Corporation
El Segundo, California

XEROX

217251

H

Sheet

7B

of

MATERIAL LIST

ML	Drawing No. 217251	Rev. H
----	-----------------------	-----------


Rev. H 3 2 1 7 2 5 1	Drawing Title	<p>These drawings and specifications, and the data contained therein, are the exclusive property of Xerox Corporation and or Rank Xerox, Ltd. Issued in strict confidence and shall not, without the prior written permission of Xerox Corporation Rank Xerox, Ltd., be reproduced, copied or used for any purpose whatsoever, except the manufacture of articles for Xerox Corporation or Rank Xerox, Ltd.</p>			
	ASSEMBLY, PRINTED WIRING-DISK & DISPLAY	Model No. NOTETAKER	Date 4-2-79	Sheet 9 of	
	NTDD8-PWASSY.SIL				
	Item No.	Drawing Title	Drawing No.	No. Req.	Remarks
	1	BOARD, PW - DISK & DISPLAY	217252	1	
	2	MICROCIRCUIT, MC14568B MOTOROLA		1	E2
ML	3	74C161 NATIONAL		5	B5,B6,C5,C6,D1
	4	82S126 SIGNETICS		1	D9
	5	82S147 SIGNETICS		1	A4
	6	CRT5027 STD MICROSYS		1	F4
	7	HA2425 HARRIS		1	C1
	8	HA508A-5 HARRIS		1	B2
	9	HD-6402 HARRIS		1	F6
	10	74 LS02 TI		1	F9
	11	74 LS04		2	A10,D2
	12	74 LS08		2	B10,F7
	13	74 LS32		2	E7, F2
	14	74 S74		1	E4
	15	74 LS109		3	A5,F10,G9
	16	74 LS123		1	A1
	17	74LS138		1	G1
	18	74 LS155		1	G2
	19	74 LS161		4	D8,D10,E1,G8
	20	74 LS164		2	E8,E9
	21	74 LS240		1	A6
	22	74 LS273		3	A2,B4,C4
	23	74 LS368		2	E10,F1
	24	74 LS374		5	A7,A8,A9,B3,C3
	25	74 LS166		2	C8,C9
	26	74 S08		1	D7
	27	74S32		2	C10,F2
	28	74S161		1	D4
	29	74S225		4	B7,B8,B9,C7
	30	MICROCIRCUIT, 74128 TI		1	G10

MATERIAL LIST





ML	Drawing No. 217251	Rev. H
----	-----------------------	-----------

Rev. H 1 2 1 7 2 5 1	Drawing Title ASSEMBLY, PRINTD WIRING- DISK & DISPLAY	These drawings and specifications, and the data contained therein, are the exclusive property of Xerox Corporation and or Rank Xerox, Ltd. Issued in strict confidence and shall not, without the prior written permission of Xerox Corporation Rank Xerox, Ltd., be reproduced, copied or used for any purpose whatsoever, except the manufacture of articles for Xerox Corporation or Rank Xerox, Ltd.		
	NTDD9-PWASSY.SIL	Model No. NOTETAKER	Date 4-2-79	Sheet 10 of


Item No.	Drawing Title	Drawing No.	No. Req.	Remarks
31	MICROCIRCUIT, HCPL273 2 HEWLETTPACK.		1	B1
32	MICROCIRCUIT, AD571 ANALOG DEV		1	C2
33	MICROCIRCUIT, W1791 WESTERN DIGIT.		1	D6
34	CAPACITOR, .047 UF, CER. AVX DG015C473M		31	C3,6-14,16,19-38
35	CAPACITOR, 22 UF, TANT. SPRAGUE 196D226X9015KA1		2	C1,2
36	CAPACITOR, 2.2 UF, TANT. CORNING MZA035-225-R-20		1	C4
37	CAPACITOR, 4.7 UF, TANT. CORNING MZA015-475-R-20		1	C5
38	CAPACITOR, .001 UF, CER. SPRAGUE CK05BX102K		1	C18
39	CAPACITOR, .01 UF, CER DISC SPRAGUE CK05BX103		2	C15,17
40	DIODE 1N914 (MOTOROLA)		3	CR1,2,3
41	TRANSISTOR, PNP 2N2905		1	Q1
42				
43	OSCILATOR, 36MHZ K1114A (MOTOROLA)		1	D3
44	RESISTOR, 150K 5%, 1/4 W FILM OR CARBON COMP		1	R1
45	180K		1	R2
46	10K		7	R3,5,9,12,16,17,22
47	5.1K		1	R8
48	18K		1	R6
49	2K		2	R7,19
50	1K		3	R10,11,21
51	510 OHM		1	R18
52	200 OHM		1	R20
53	RESISTOR, 150 OHM 5%, 1/4 W FILM OR CARBON COMP		4	R4,13,14,15
54				
55	SOCKET, IC 8 PIN AUGAT # 508-AG11D		1	
56	SOCKET, IC 14 PIN AUGAT # 514-AG11D		15	
57	SOCKET, IC 16 PIN AUGAT # 516-AG11D		23	
58	SOCKET, IC 18 PIN AUGAT # 518-AG11D		1	
59	SOCKET, IC 20 PIN AUGAT # 520-AG11D		14	
60	SOCKET, IC 40 PIN AUGAT # 540-AG11D		3	

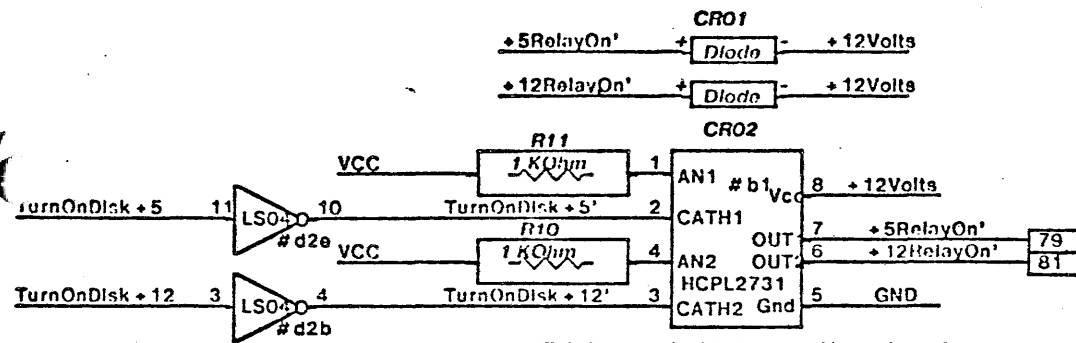

This is an optical Isolator and is packaged as an 8 pin mini-dip. (HCPL-2731)

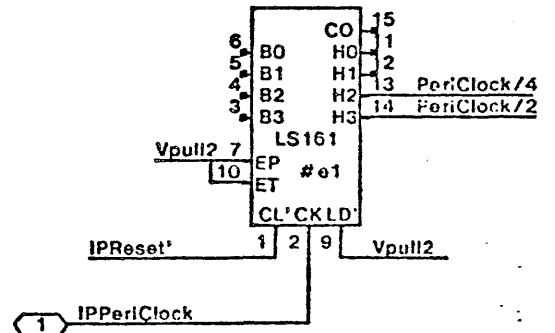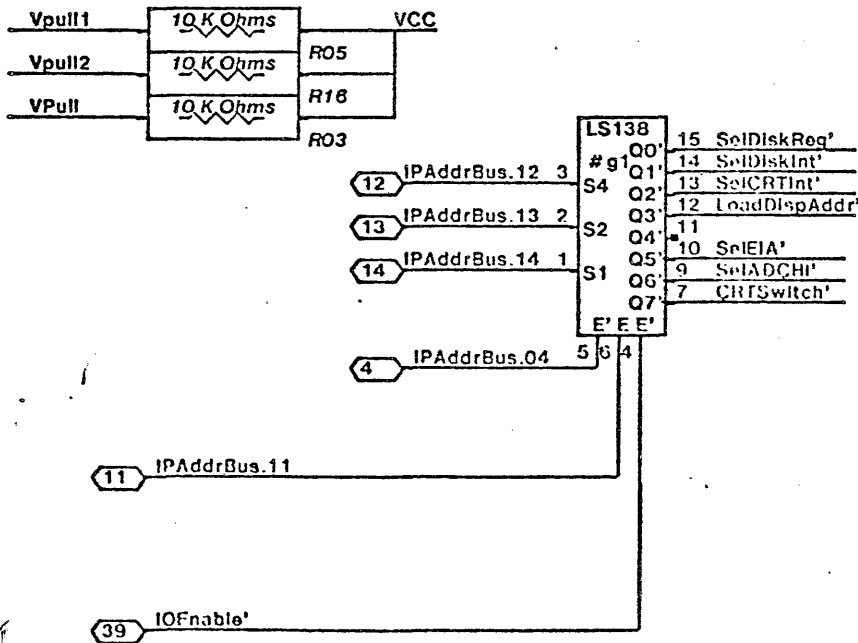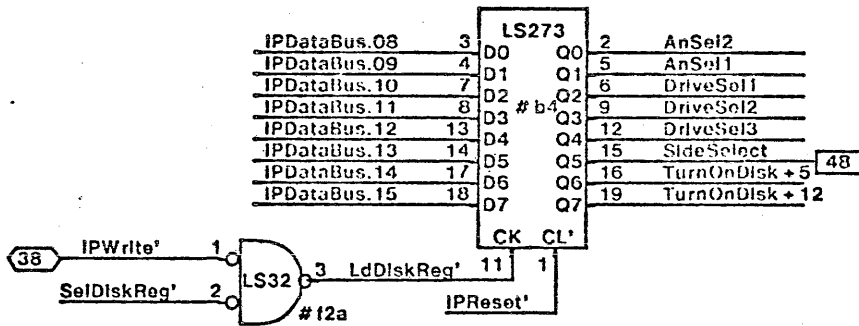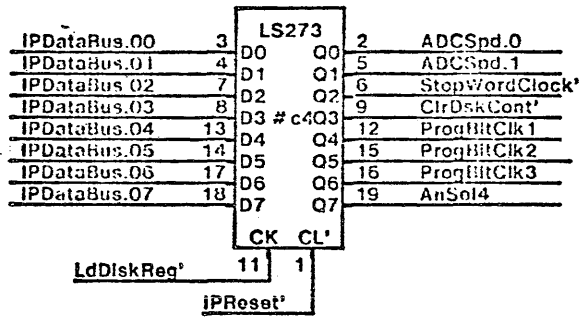


Note: The DiskInt signal will probably not work because it is active high and they are wire ORed. One may have to be eliminated.

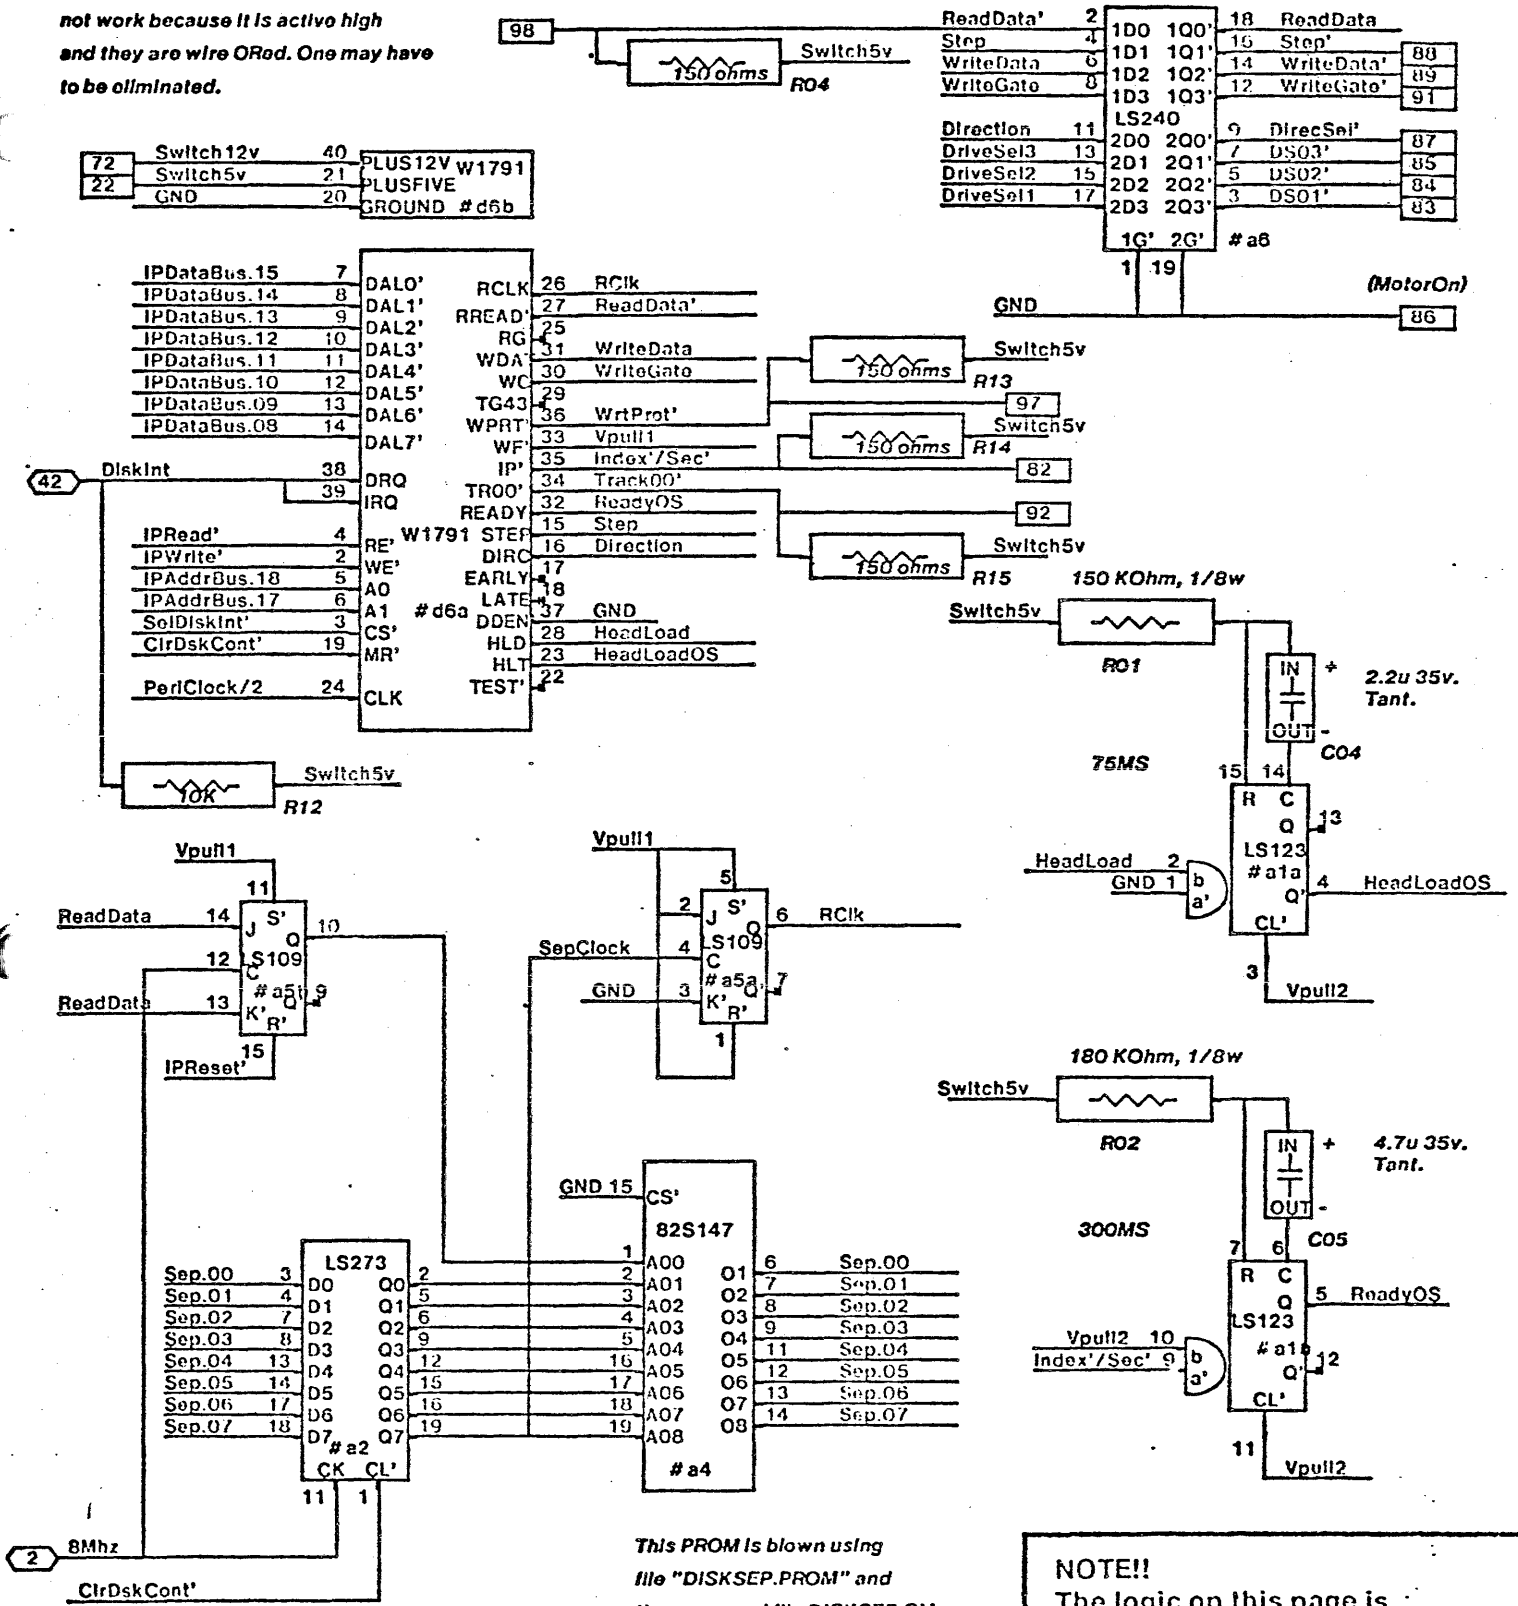


This PROM is blown using file "DISKSEP.PROM" and the command file DISKSEP.CM





NOTE!!
 The logic on this page is powered from the "Switch5v" line (pin 21) instead of the normal 5 volt supply
 The +12v for the W1791 comes from Switch 12v as shown

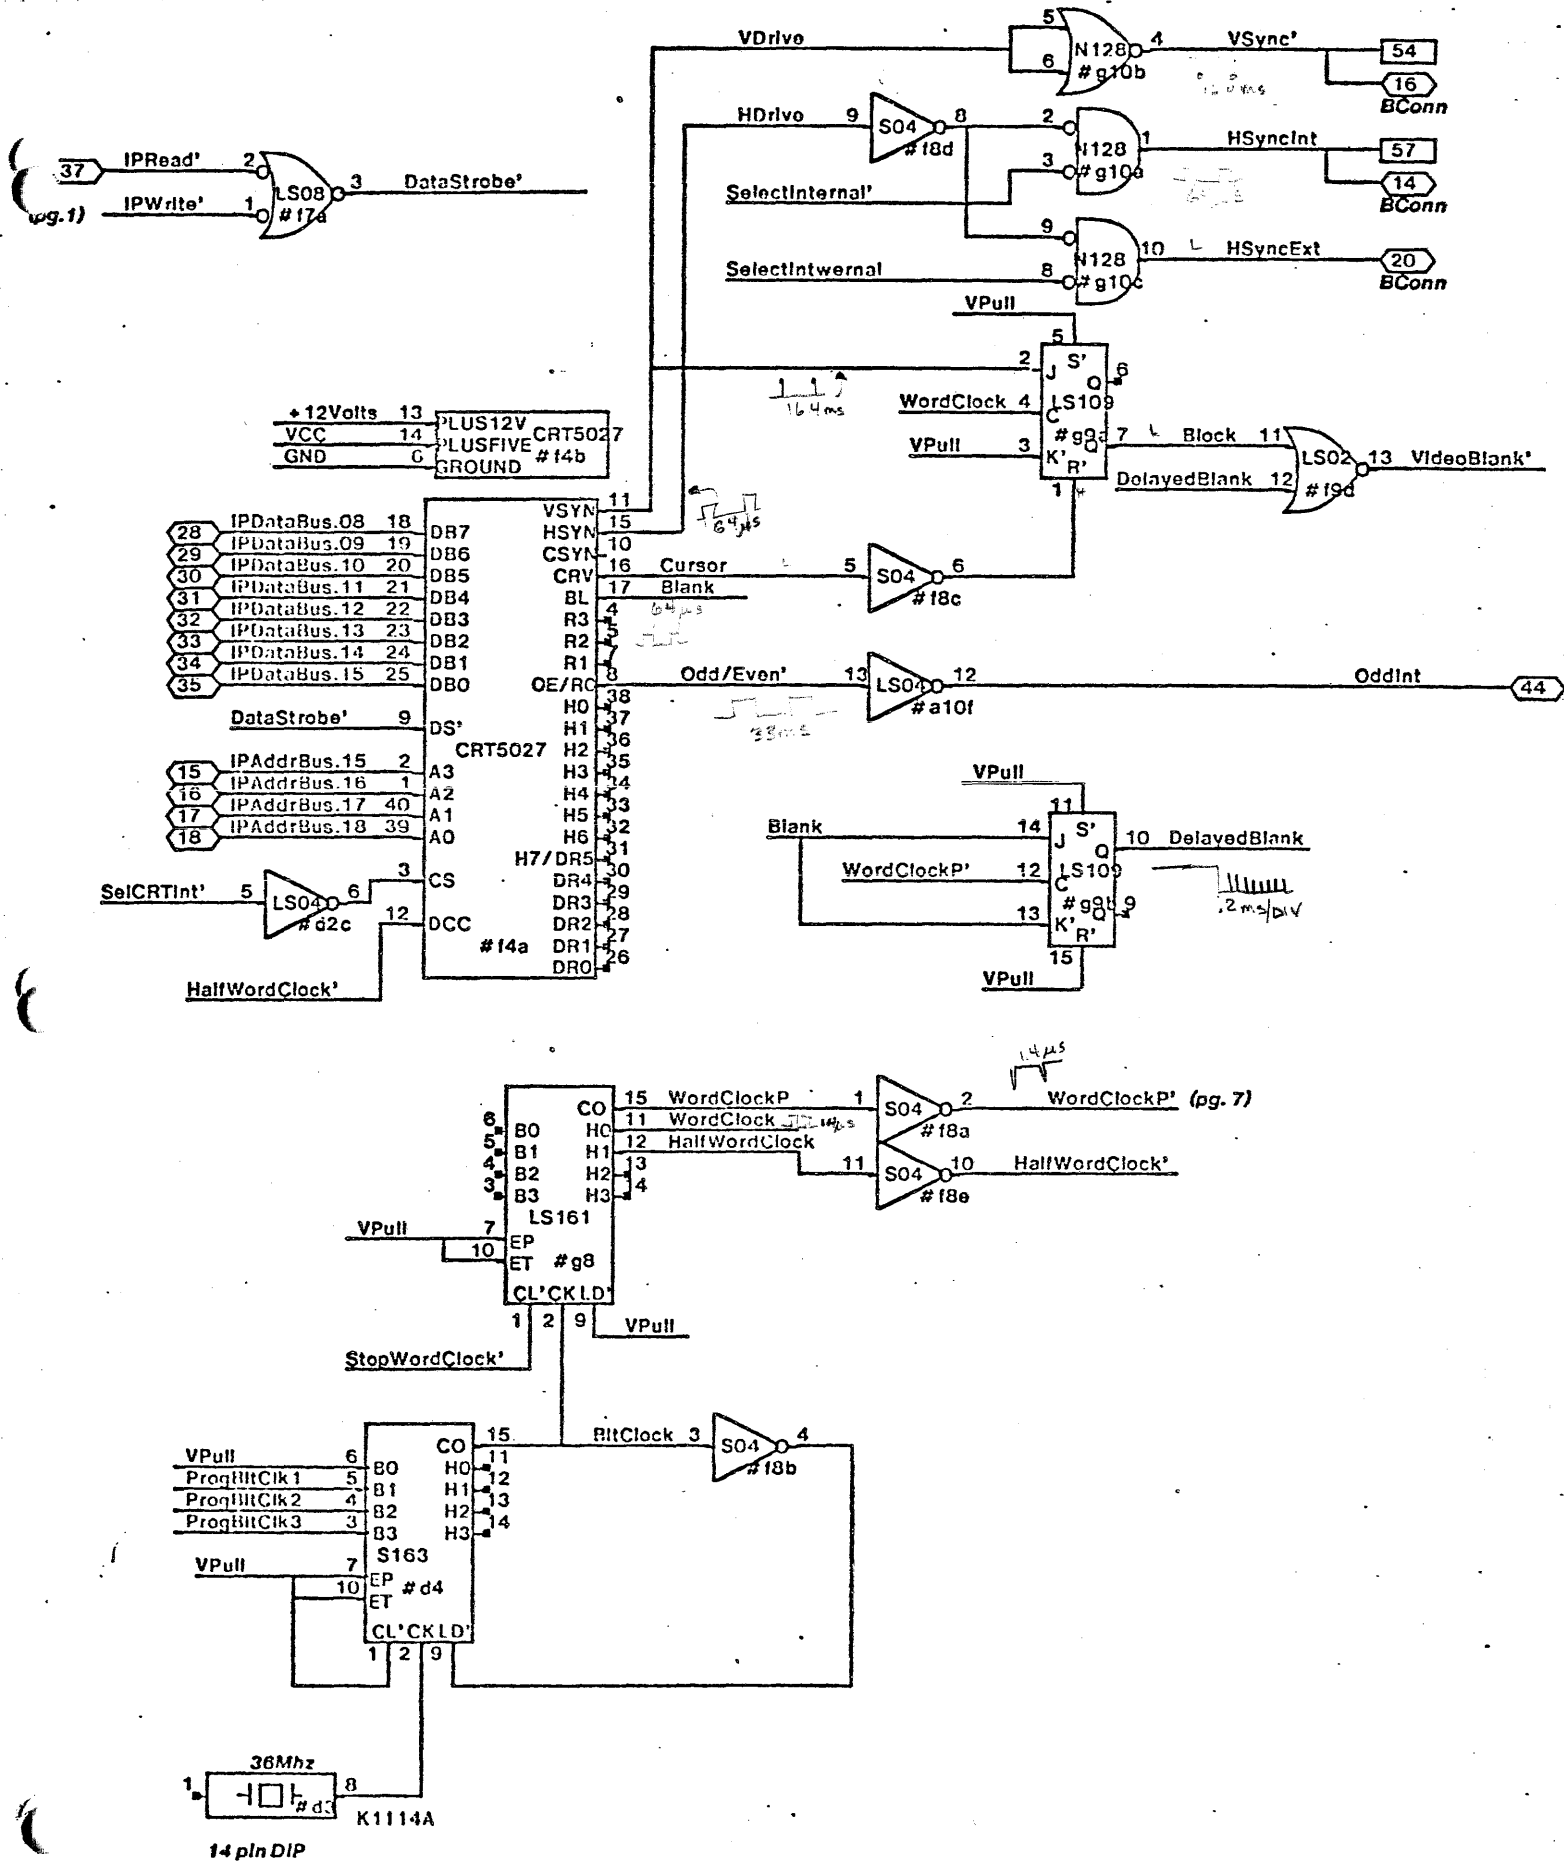




XEROX SPG	Project	Disk/Display Controller	File	Date	Dwg. No.	Rev	Page
	NoteTaker		PNTDD03.sil				
			Designer				
			Ron Freeman				

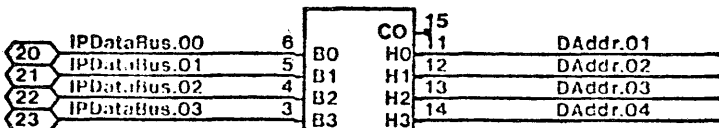

DISPLAY MEMORY ADDRESS COUNTER

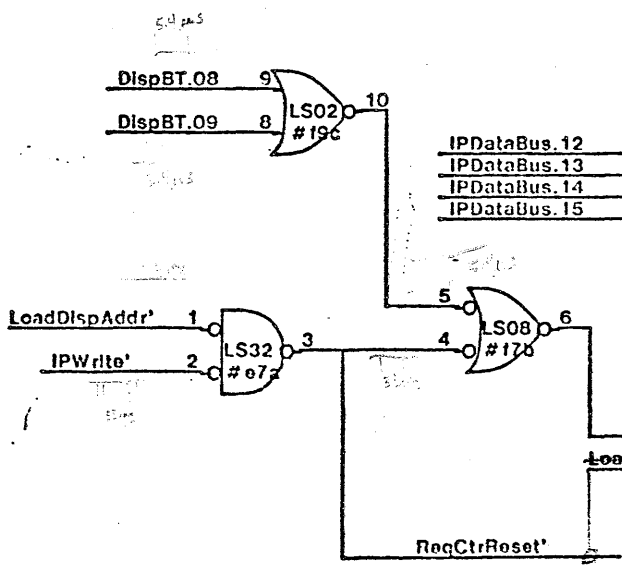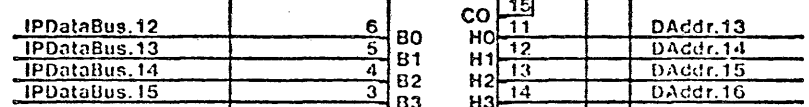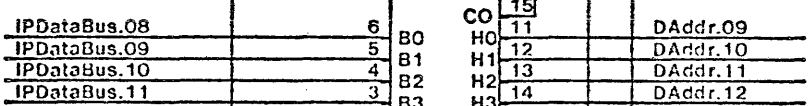
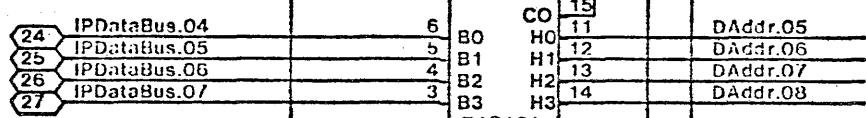


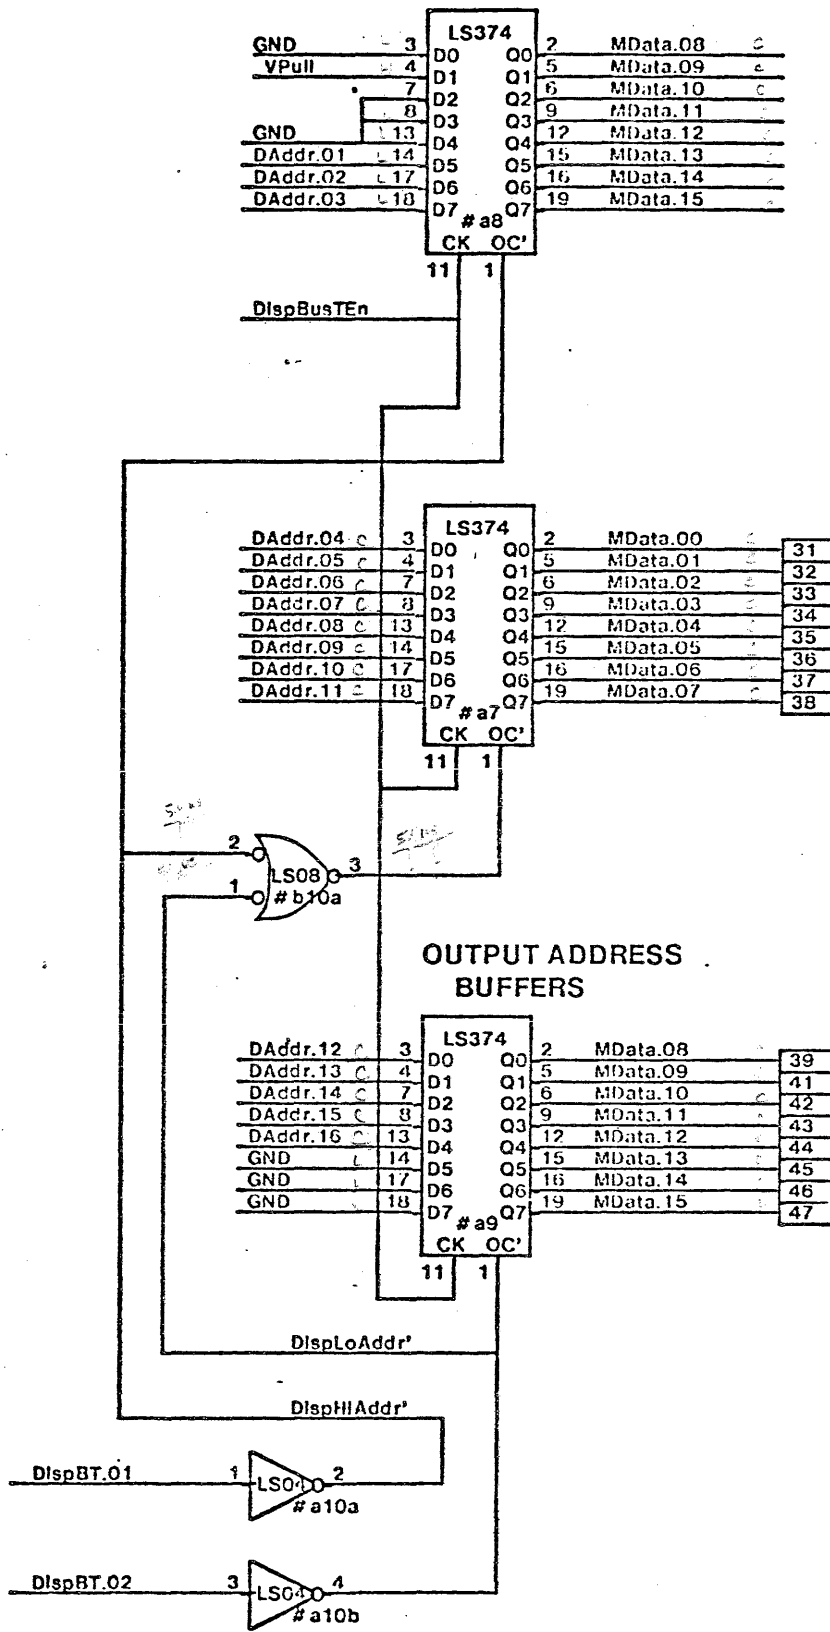

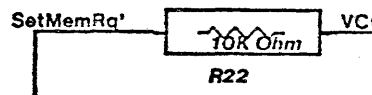
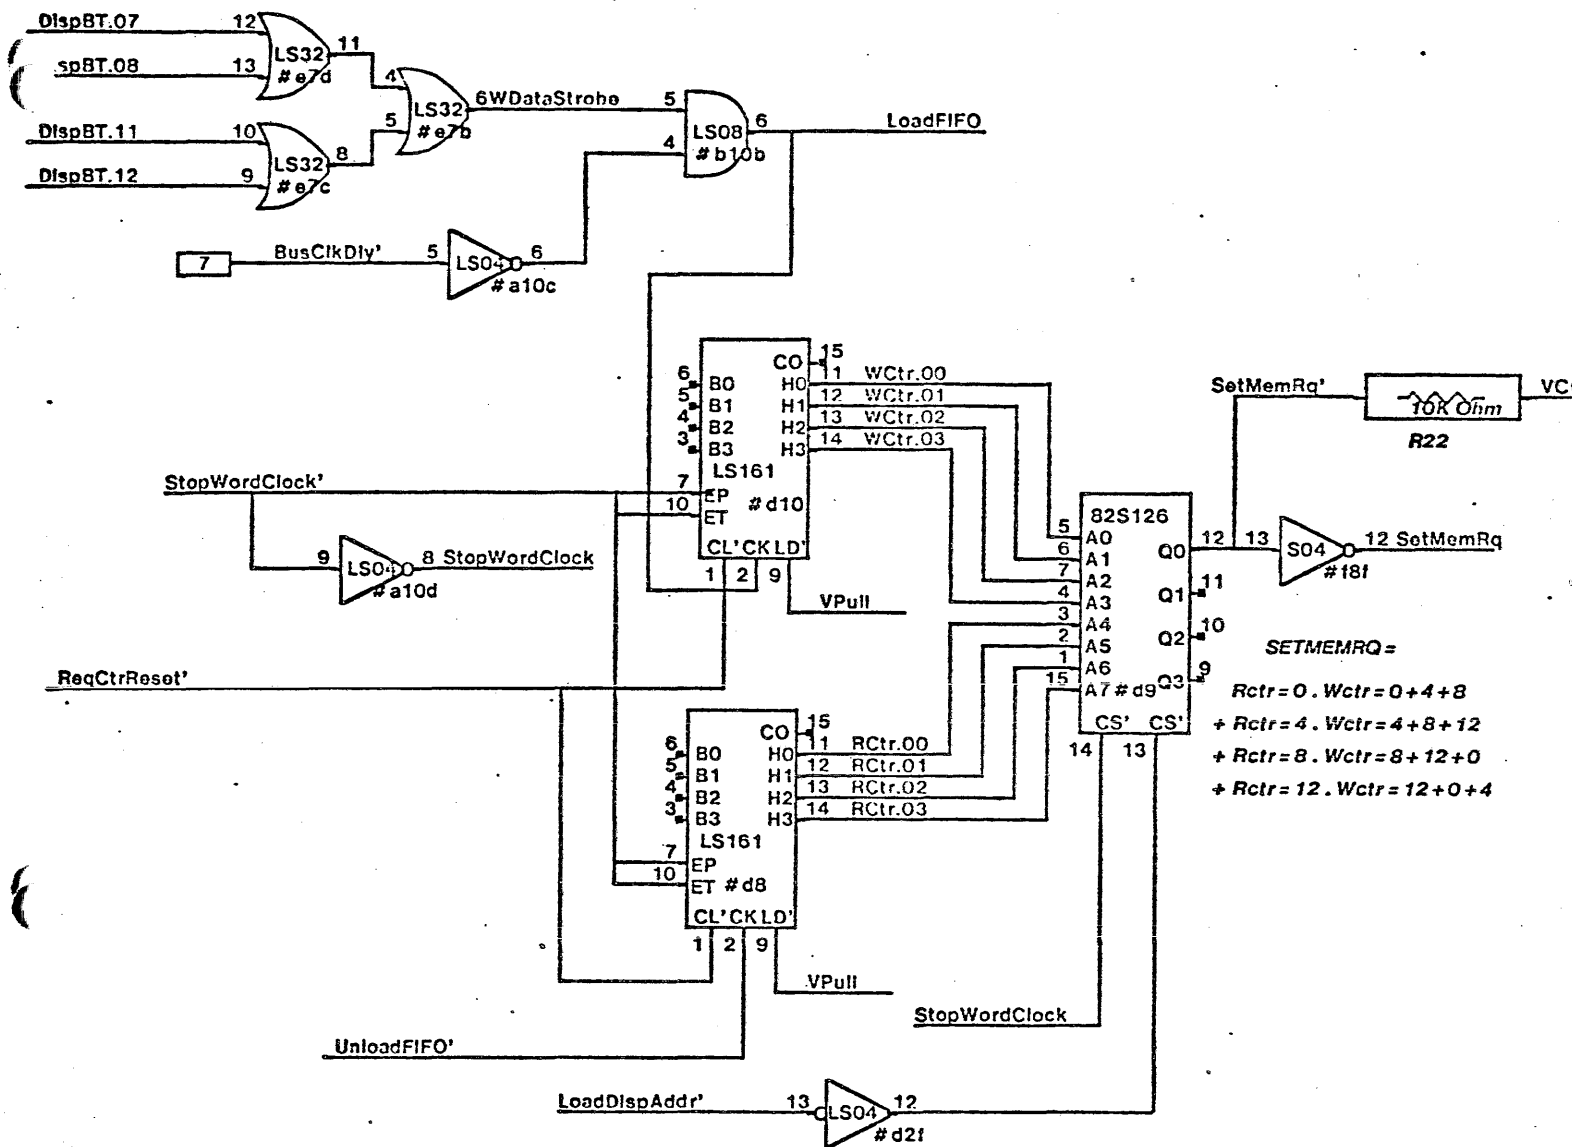


SETMEMRQ =
 $Rctr = 0 . Wctr = 0 + 4 + 8$
 $+ Rctr = 4 . Wctr = 4 + 8 + 12$
 $+ Rctr = 8 . Wctr = 8 + 12 + 0$
 $+ Rctr = 12 . Wctr = 12 + 0 + 4$

Note: 330pf connected between 2d13 and GRD.



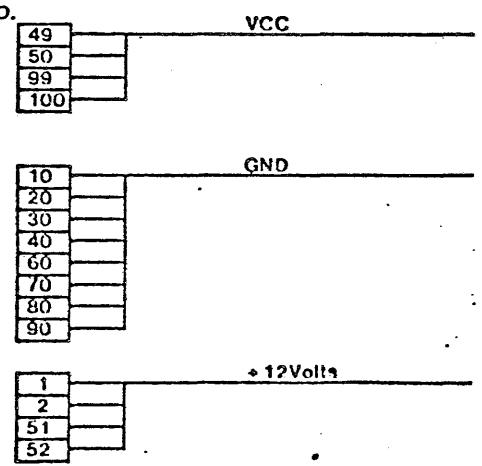
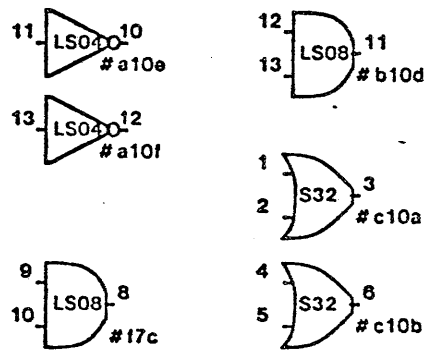





XEROX SPG	Project	Disk/Display Module FIFO Control Logic	File	Date	Dwg. No.	Rev	Page
	NoteTaker		PNTDD06.sil				
			Designer	FREEMAN			




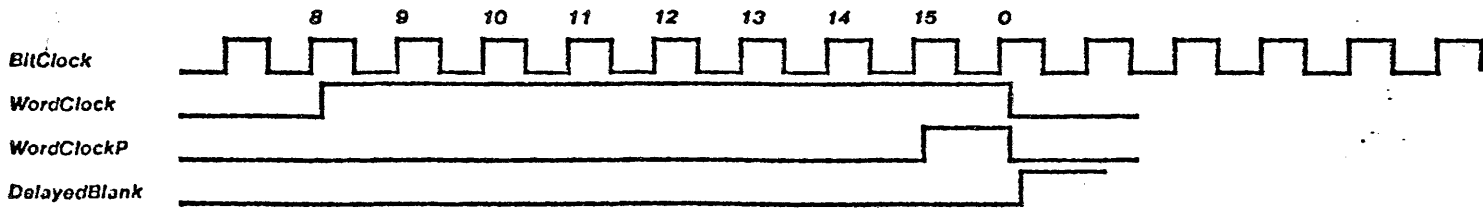
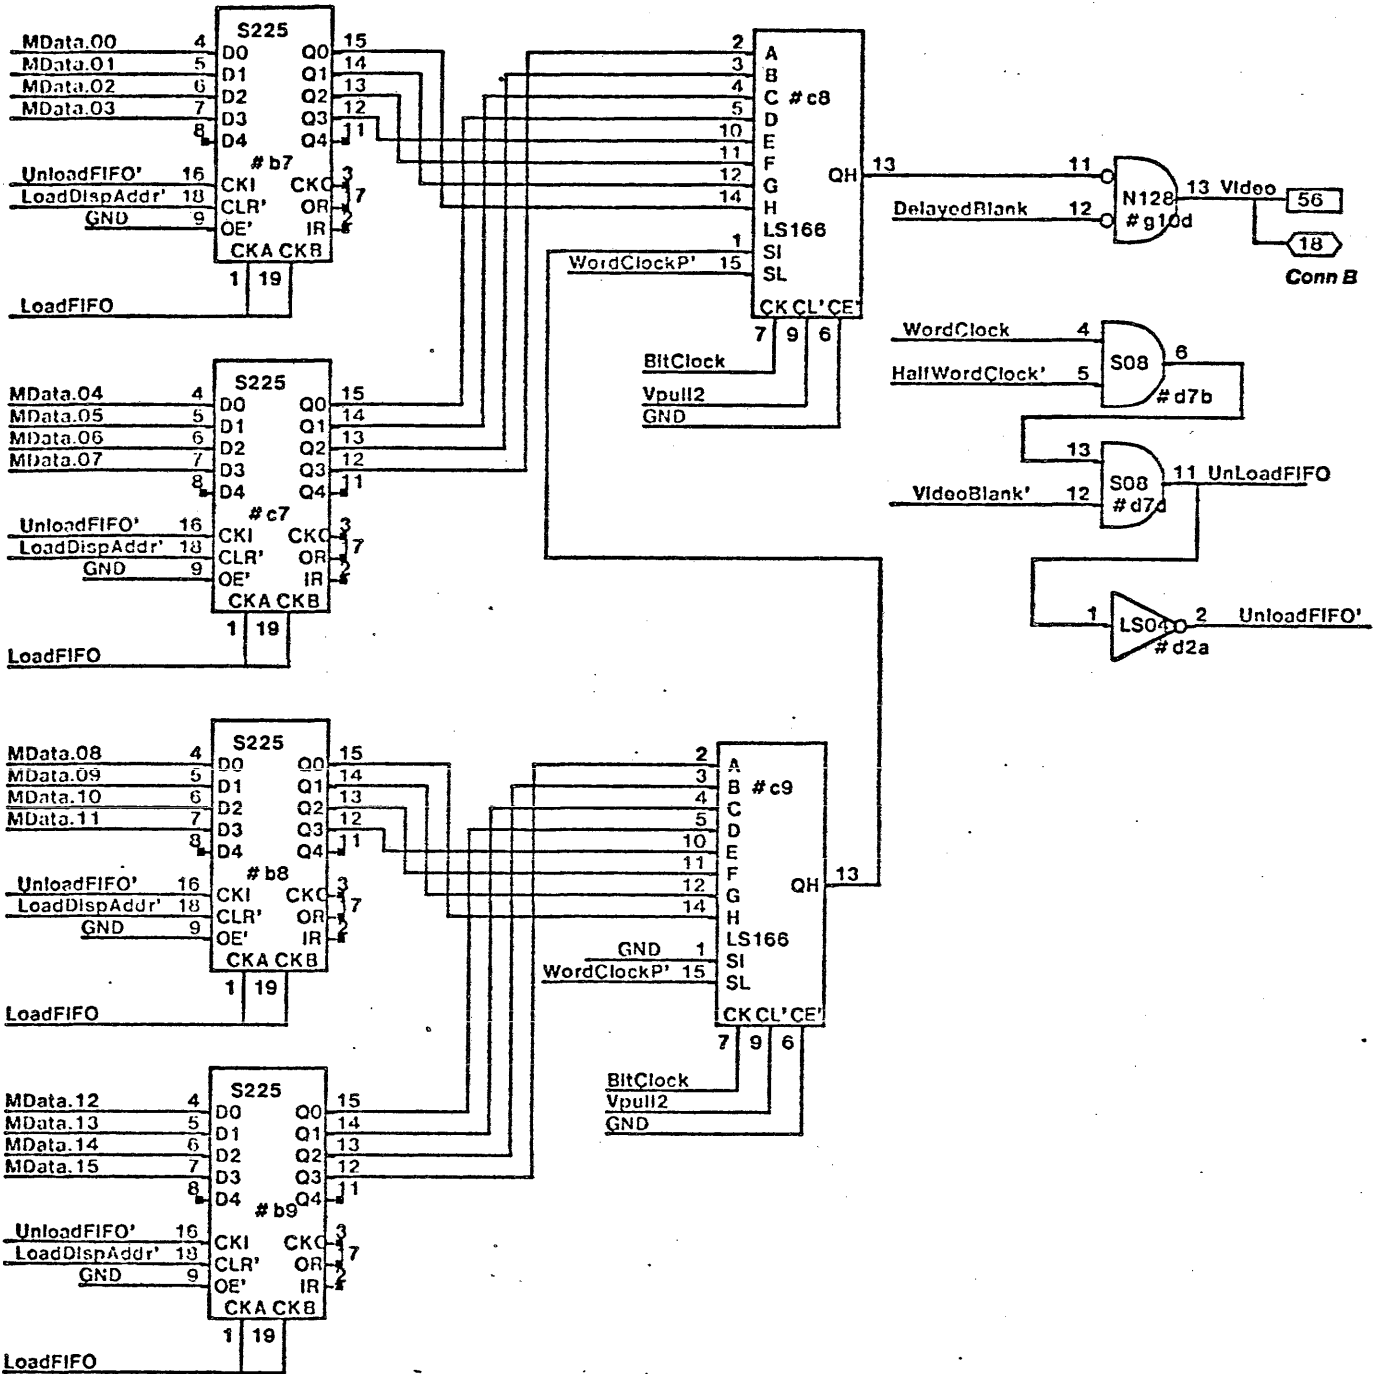


Shift register loaded here


XEROX SPG	Project NoteTaker	Disk/Display Module Display Buffers (FIFOs)	File PNTDD07.sii	Date 4/19/79	Dwg. No. 217251	Rev H	Page 18
			Designer FAIRBAIRN				

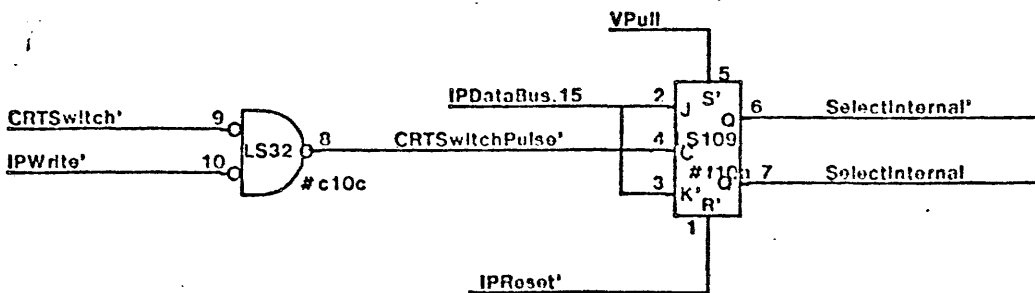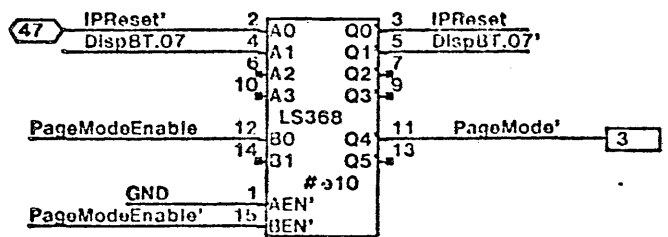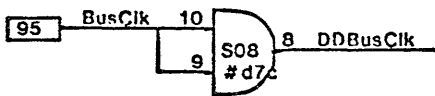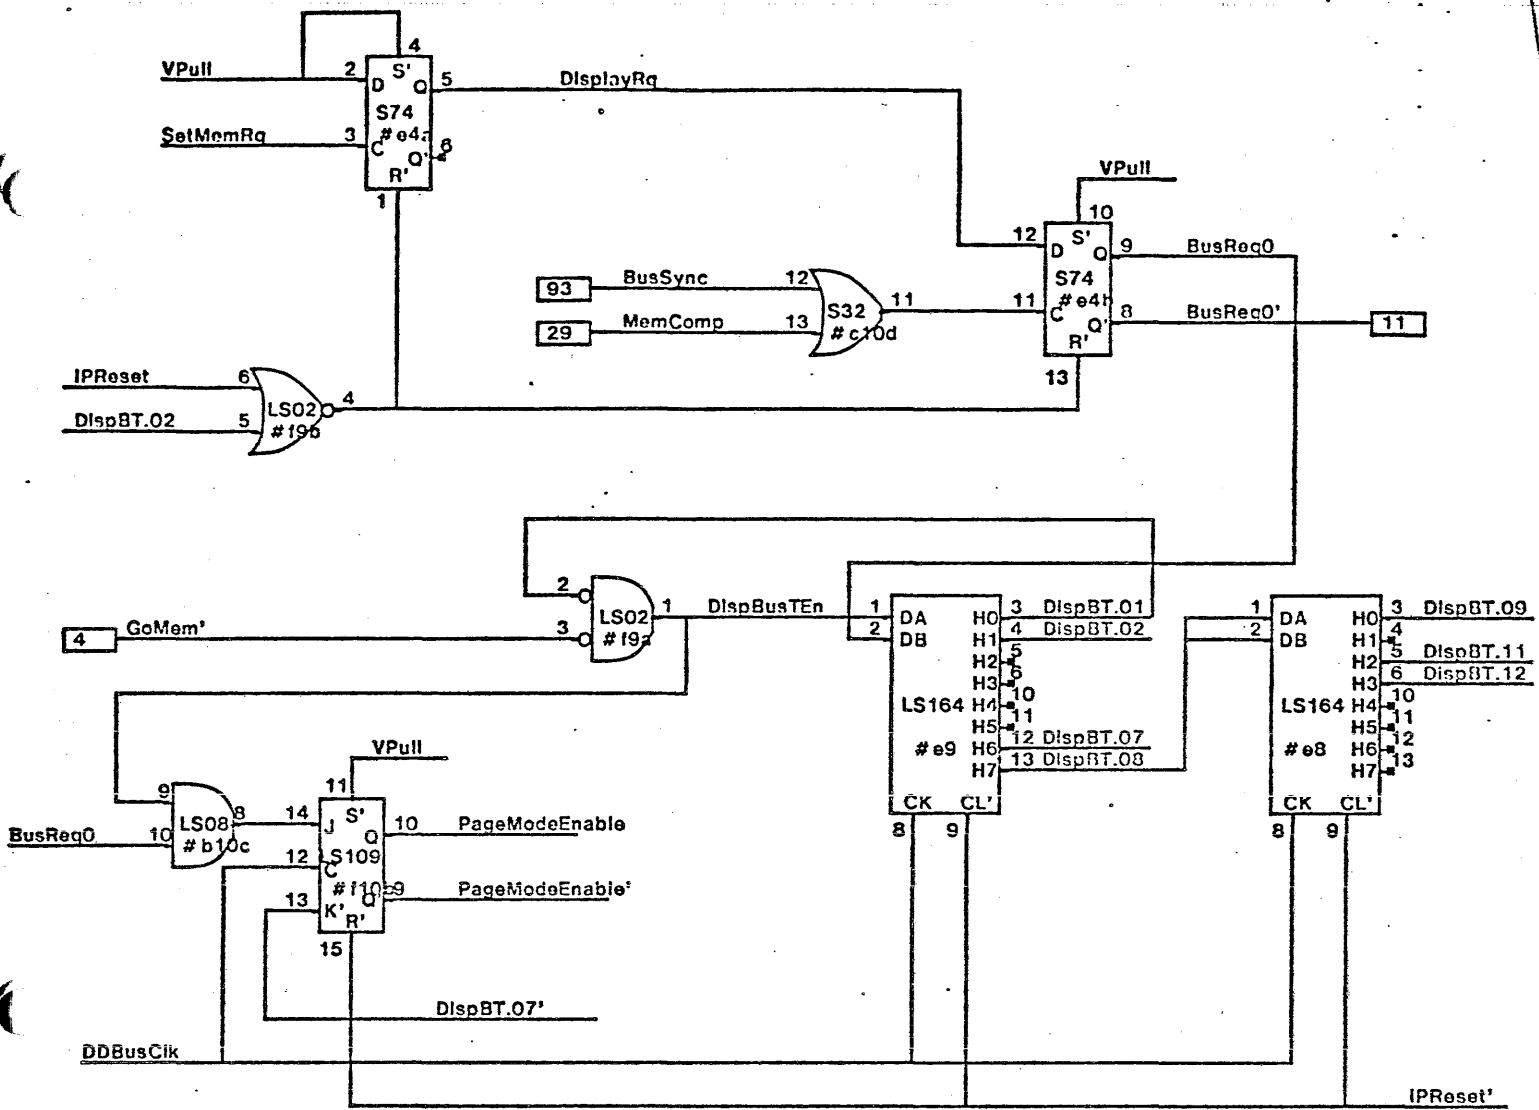

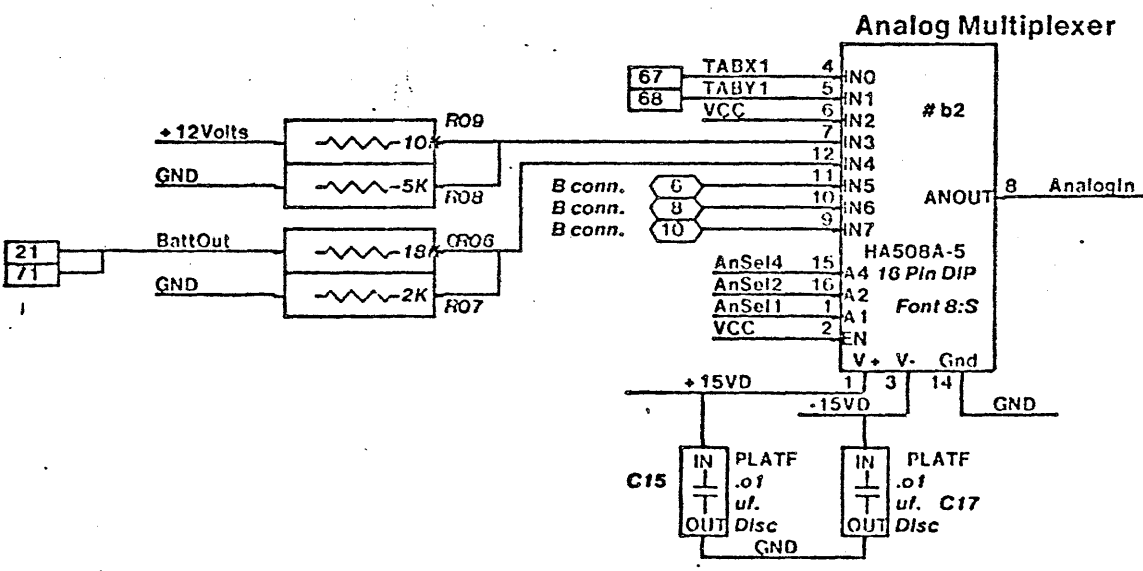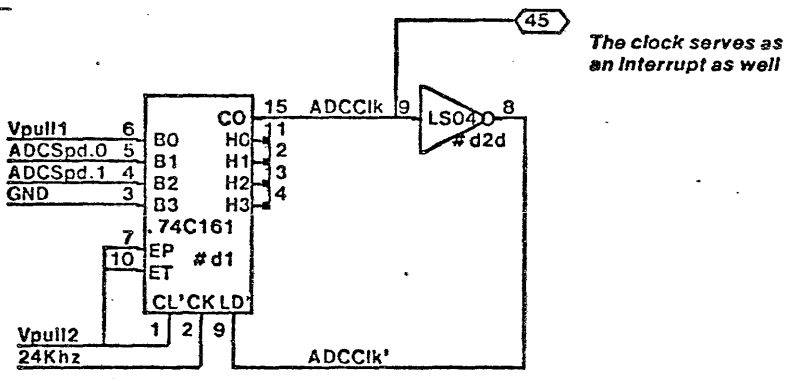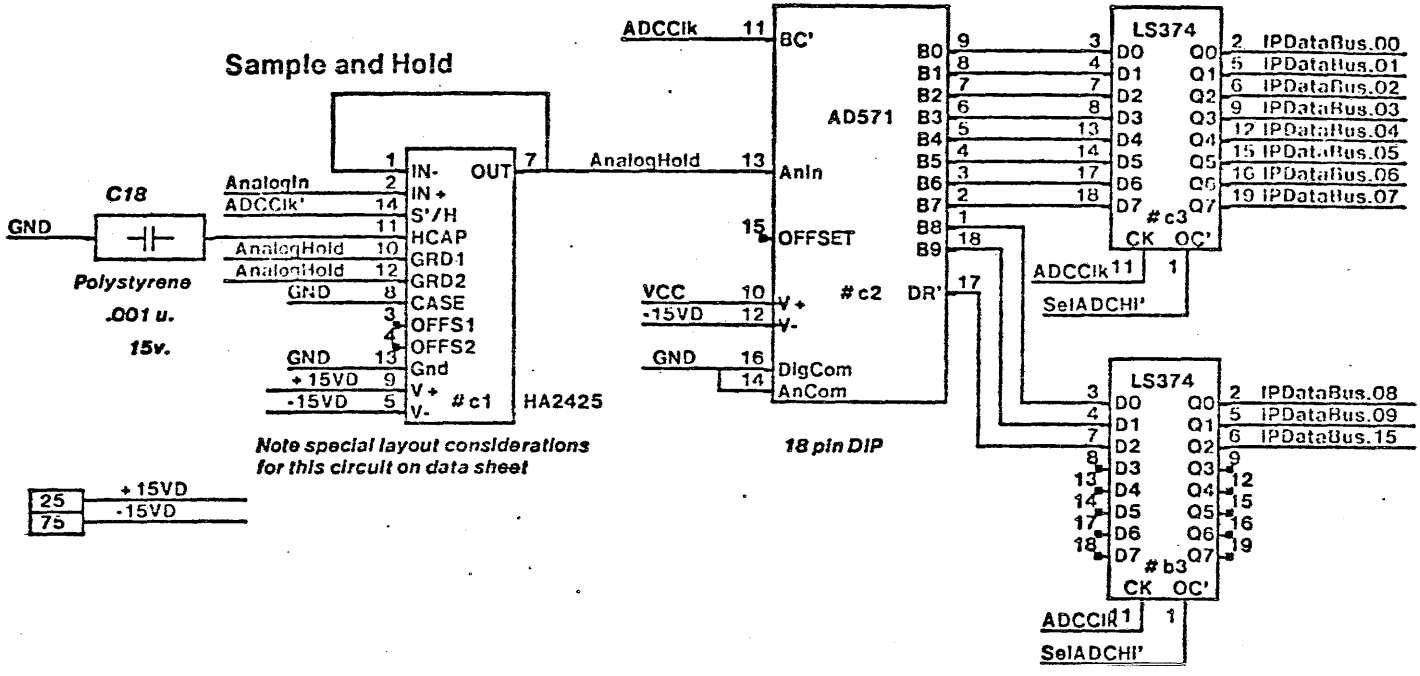

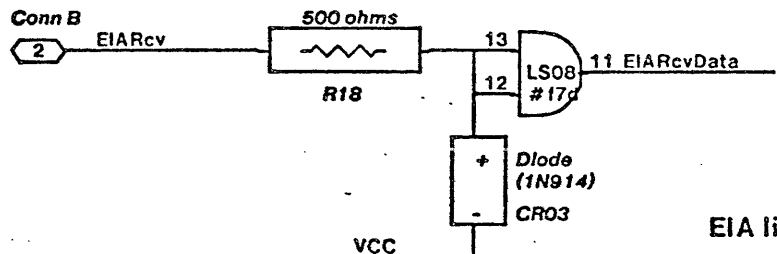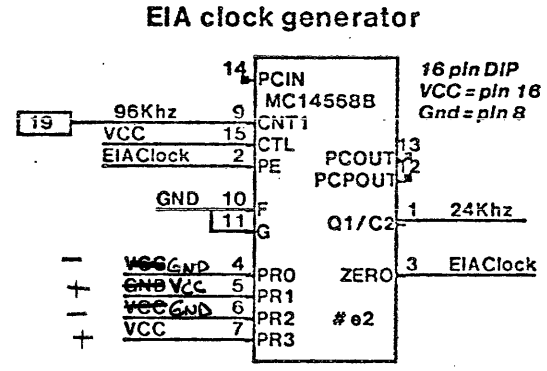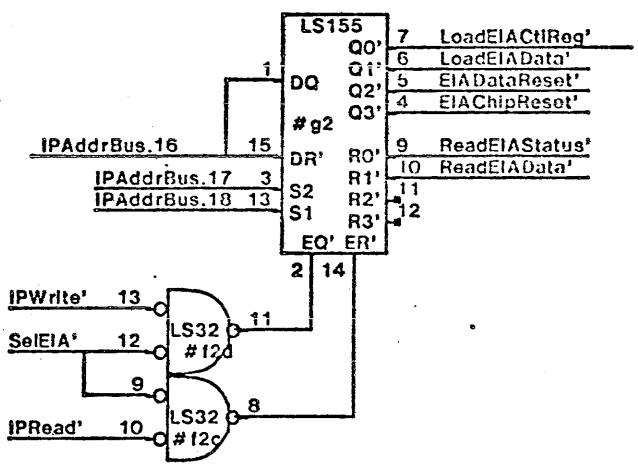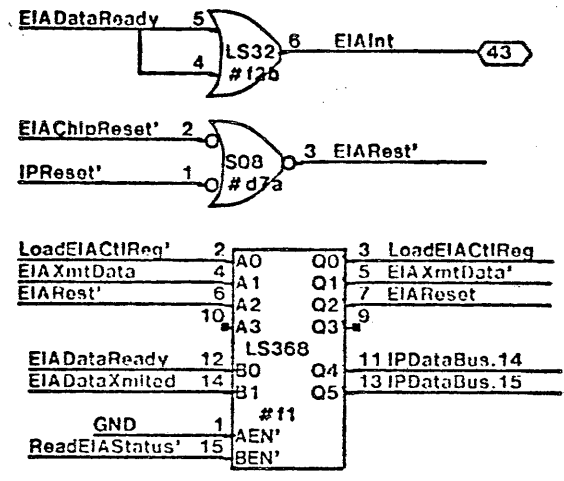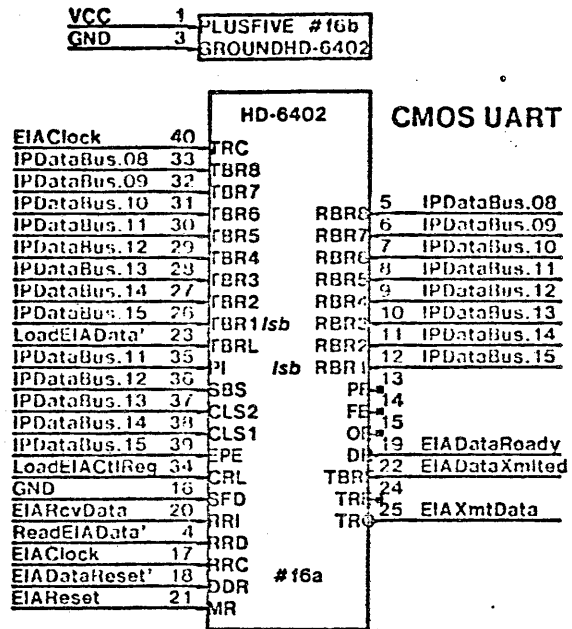

EIA line drivers and receivers

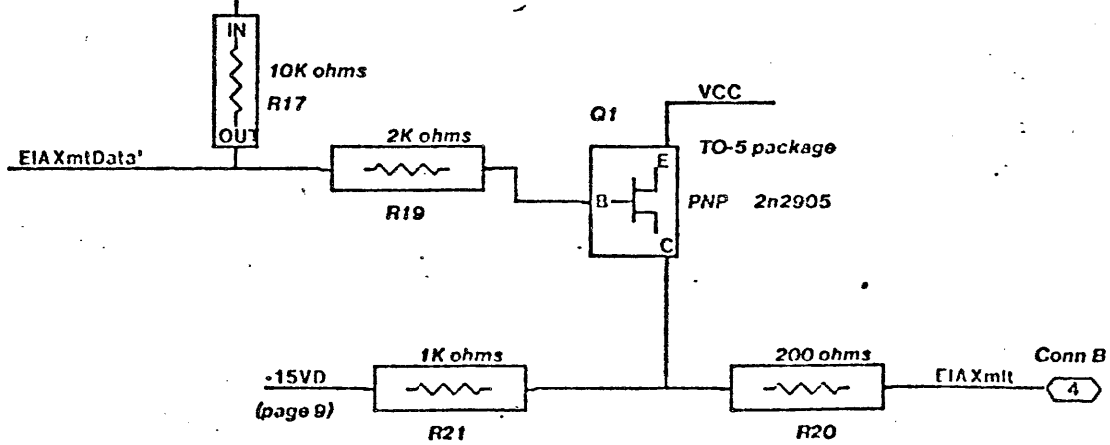

XEROX SPG	Project NoteTaker	Disk/Display Module EIA interface	File PNTDD10.sil	Date 4/19/79	Dwg. No. 217251	Rev H	Page 21
			Designer Ron Freeman				